


AS-BUILT - PM VERIFIED
GALLERIA TOWERS
1447 YORK ROAD
SUITE 100
LUTHERVILLE, MD
12,303 RENTABLE SQ.FT.

SCALE: N.T.S.
 DATE: 3/8/22
 REVISED:
 DESIGNER: DEC



Hill Management Services, Inc.
 9640 Deereco Road
 Timonium, Maryland 21093
 (410) 666-1000
 www.hillmgt.com

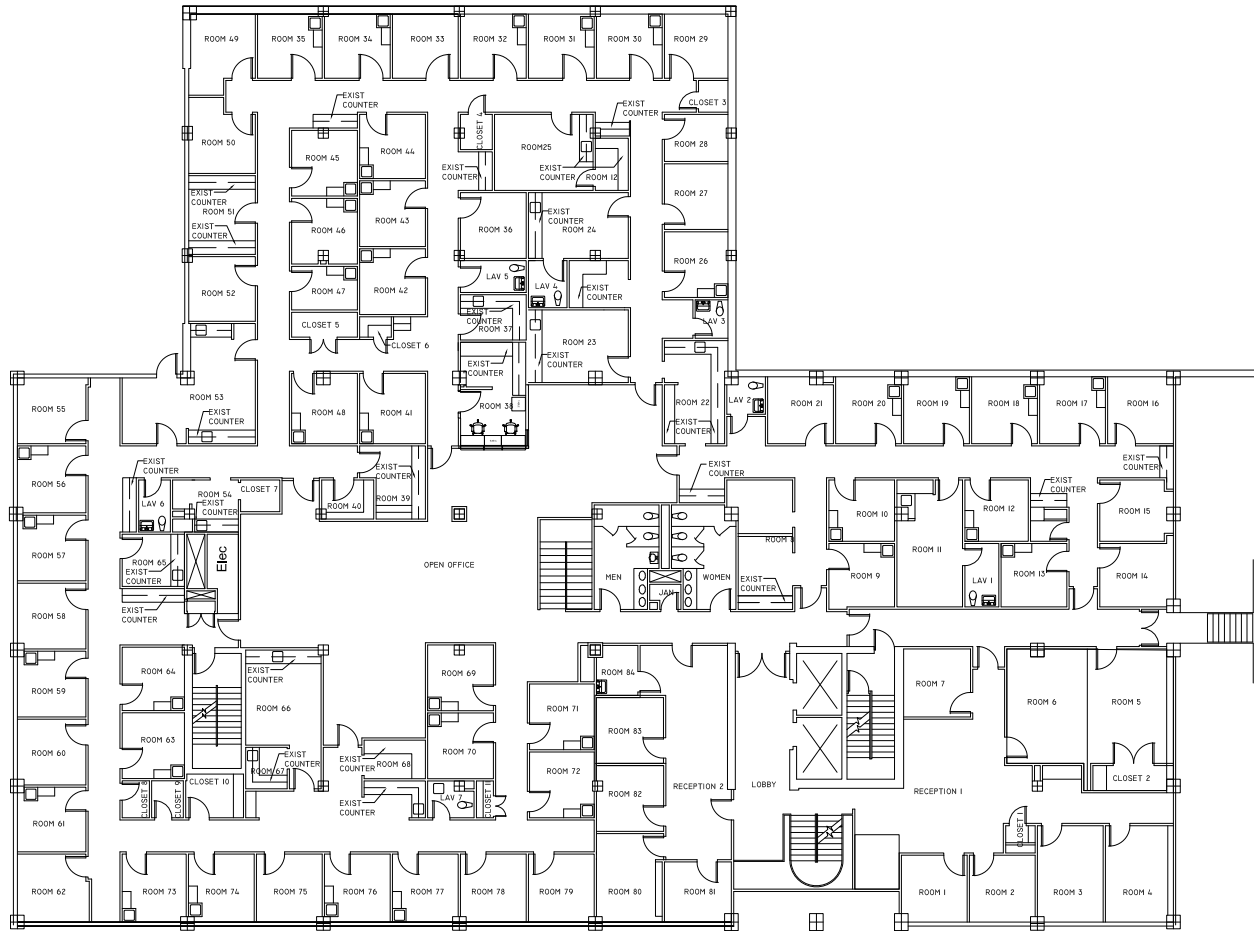

AS-BUILT - NOT VERIFIED
 GALLERIA TOWERS
 1447 YORK ROAD
 SUITE 200
 LUTHERVILLE, MD
 18,612 RENTABLE SQ.FT.

SCALE: N.T.S.
 DATE: 11/4/21
 REVISED:
 DESIGNER: DEC



Hill Management Services, Inc.
 9640 Deereco Road
 Timonium, Maryland 21093
 (410) 666-1000
 www.hillmgt.com