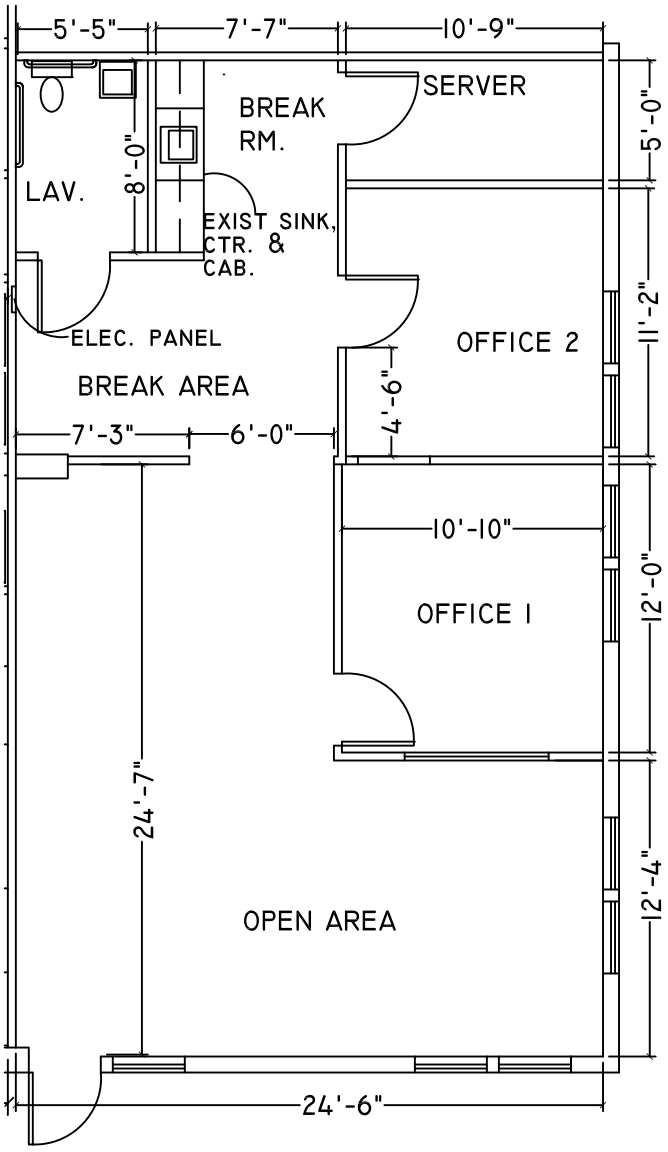

AS-BUILT
EASTPOINT OFFICE PARK
1005 NORTH POINT BLVD.
STE. 729
BALTIMORE, MD
1,108 RENTABLE SQ.FT.

SCALE: N.T.S
DATE: 1/04/2021
REVISED:

Hill Management

Hill Management Services, Inc.
9640 Deereco Road
Timonium, Maryland 21093
(410) 666-1000
www.hillmgt.com

F:\Drawings-PDF\CAD\Drawings\Commercial\Eastpoint\1005\AA- As Builts\ste729 010421.dwg