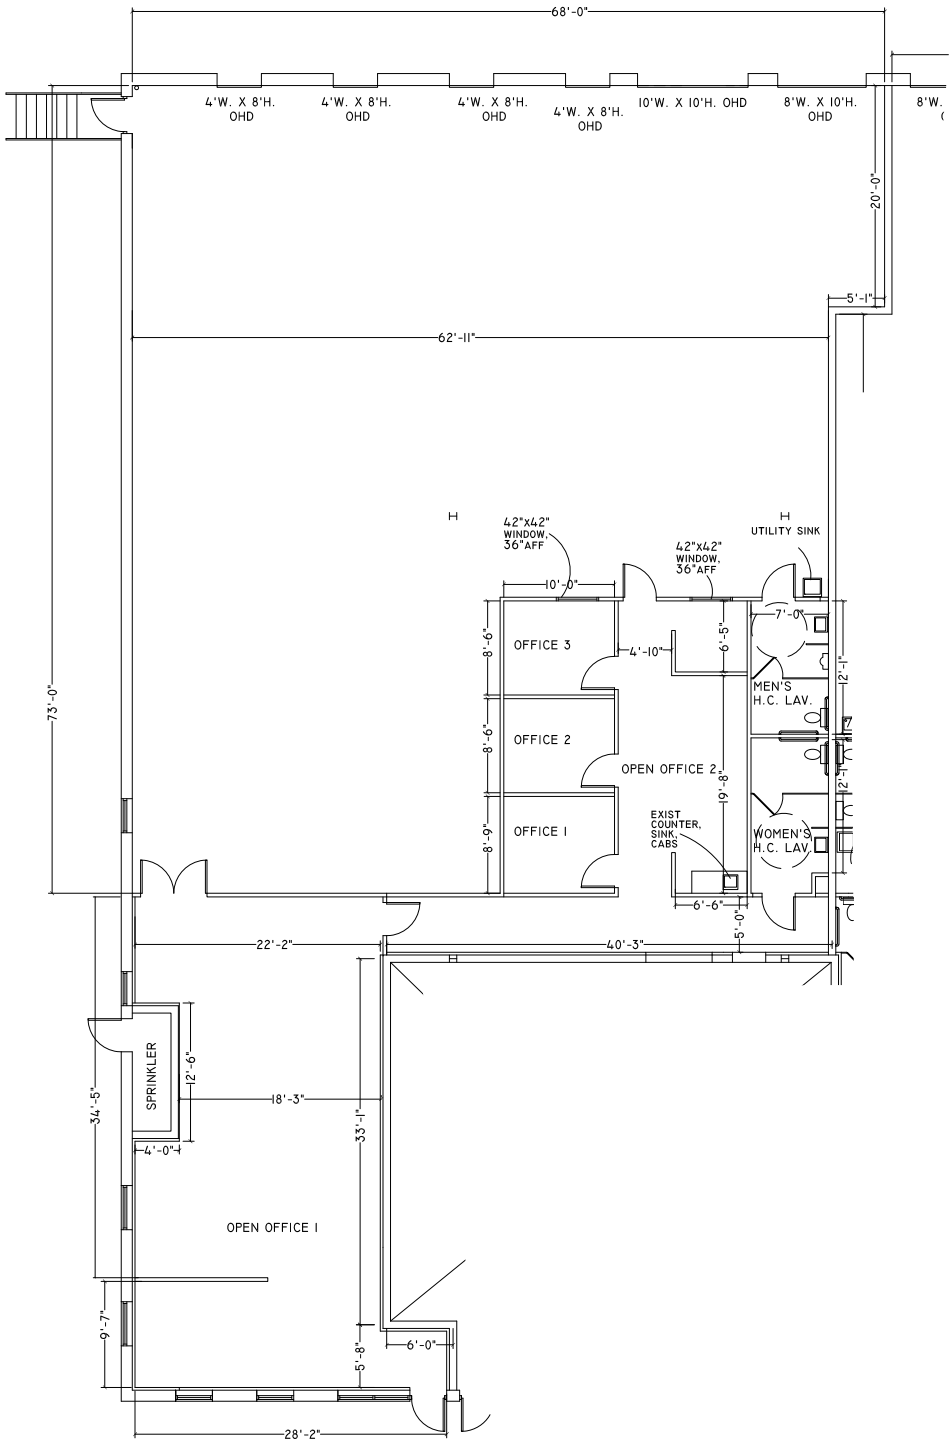

AS-BUILT- PM VERIFIED

BWCP- 7389 WASHINGTON BLVD.
SUITES 101, 101R, 102R
ELKRIDGE, MD
6,192 RENTABLE SQ.FT.
(includes 2,125 sq.ft. of office space)

SCALE: N.T.S.
DATE: 2/15/2022
REVISED:

Hill Management

Hill Management Services, Inc.
9640 Deereco Road
Timonium, Maryland 21093
(410) 666-1000
www.hillmgt.com

F:\Drawings-PDF\CAD\Drawings\Commercial\BWCP\7389\AA-Asbuilts\ste101-102 020122.dwg